

Municipal Information Renseignements municipaux

Return completed form to:
Alcohol and Gaming
Commission of Ontario
90 Sheppard Avenue, East
Suite 200
Toronto ON M2N 0A4

Remplir et retourner cette
formule à :
Commission des alcools
et des jeux de l'Ontario
90, avenue Sheppard Est
Bureau 200
Toronto ON M2N 0A4



The information requested below is required in support of all applications for a **new** liquor licence or outdoor areas being added to an **existing** liquor licence.

Les renseignements sont recueillis conjointement à toute demande de **nouveau** permis d'alcool ou d'ajout de zones de plein air à un permis d'alcool existant.

Section 1 - Application Details

Section 1 - Détails de la demande

Establishment name/Nom de l'établissement

i SHOT GOLF

Establishment tel. no./ N° de tél. de l'établissement

905-752-0168

Contact name/Nom de la personne à contacter

CARLO PIEROZZI

Contact's tel. no./ N° de tél. de la personne à contacter

647-456-7376

Exact location of establishment (not mailing address - street number and name, city or lot no., concession and township)

Emplacement exact de l'établissement (non l'adresse postale - numéro et nom de la rue, ville ou numéro de lot, concession et canton)

7501 WOODBINE AVENUE, UNIT 7, MARKHAM

Does the application for a liquor licence include:/La demande de permis d'alcool porte-t-elle entre autres sur :

☒ indoor areas/des zones intérieures ☒ outdoor areas/des zones de plein air

Section 2 - Municipal Clerk's official notice of application for a liquor licence in your municipality

Section 2 - Avis officiel de demande de permis d'alcool dans votre municipalité à l'intention du (de la) secrétaire municipal(e)

Municipal Clerk -
please confirm the "wet/damp/dry" status below.

Secrétaire municipal(e) :
Confirmer le statut de la région ci-dessous.

Name of village, town, township or city where taxes are paid/Nom du village, de la ville ou du canton à qui les impôts sont versés :

(If the area where the establishment is located was annexed or amalgamated, provide the name of the Village, Town, Township or City was known as)

(Si la région où se trouve l'établissement a été annexée ou fusionnée, nom sous lequel le village, la ville ou le canton était connu)

Is the area where the establishment is located:/ La vente de boissons alcooliques est-elle autorisée dans la région où se trouve l'établissement?

☐ Wet (for spirits, beer, wine)/Oui (spiritueux, bière, vin) ☐ Damp (for beer and wine only)/Oui (bière et vin seulement) ☐ Dry/Non

Note:

Specify concerns regarding zoning, non-compliance with bylaws, or general objections to the application by council or elected municipal representatives, must be clearly outlined, in a **separate submission or letter within 30 days of this notification.**

Remarque :

Toute question particulière concernant le zonage, la non-conformité aux règlements municipaux ou toute objection générale relative à la demande de la part de membres du conseil ou de représentants municipaux élus doit être décrite clairement **dans un document distinct ou une lettre à l'intérieur d'une période de 30 jours après la remise du présent avis.**

Signature of municipal official/Signature du (de la) représentant(e) municipal(e)

Title/Poste

Address of municipal office/Adresse du bureau municipal

Date



FEE \$ 110.50


D. L. H.

Town of Markham

LIQUOR LICENCE QUESTIONNAIRE

*To enable our evaluation of your liquor licence application, the following information is required.
Please return the completed form to the Clerk's Department.*

1.	What type of restaurant is proposed?	☐ Family ☐ Roadhouse ☐ Sports Bar ☐ Fine Dining ☐ Take Out ☒ Café
2.	a) What type of Food will be served:	Varied menu ☒ Specialty ☐ Snacks ☒
	b)	☒ Menu attached (Please note, a copy of the menu is required with all applications)
3.	What entertainment or amusements will be provided?	☐ Karaoke ☐ Live entertainment ☐ Casino ☐ Off-track betting ☐ Arcade ☒ EXISTING INDOOR SIMULATORS GOLF STAGE
4.	a)	The maximum seating capacity will be <u>100</u> persons.
	b)	Where the restaurant is existing, the previous seating capacity was _____ persons.
5.	a)	Was this premises previously used as a restaurant? ☒ Yes ☐ No (Note: If the answer to this question is no, a building permit will be required) * SAME JUST INCREASE SIZE
	b)	If this premises was previously used as a restaurant, is any construction or alteration proposed? ☒ Yes ☐ No (If the answer to this question is yes, a building permit will be required) ✓
6.	Has a building permit been applied for or obtained in connection with these premises?	☒ Yes Permit No. <u>11-132 000 000 00</u> ☐ No Provide 1 copy of the floor plan showing the dimensioned floor layout, floor areas to be licenced, seating arrangements, washrooms (show fixtures) and exits.
7.	Does the building on the premises have a fire alarm system?	☒ Yes ☐ No
8.	Were the premises previously licenced?	☒ Yes ☐ No
9.	Is the liquor licence application for an expansion of the existing operations?	☒ Yes ☐ No (If yes, please provide details on a separate page) * YES Applied to AGCO NOVEMBER 2011
10.	What is the nearest major intersection to the proposed location?	<u>WOODBINE / STEELES</u>
11.	What is the distance to the nearest residential area?	<u>+1 KM</u>
12.	a) Your name (Please print)	b) Contact Telephone No.
	<u>CARLO PIEROZZI</u>	Bus: <u>647 456 7376</u>
		Res: _____
	c) The restaurant's name	<u>i SHOT GOLF</u>

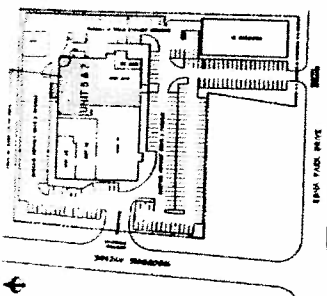

KEY PLAN - N.T.S.

DATE	REVISION	BY
2011/09/24	ISSUED FOR COORDINATION	P.P.
2011/11/04	ISSUED FOR CLIENT APPROVAL	P.P.
2011/11/14	ISSUED FOR BUILDING PERMIT	P.P.
2011/11/22	RE-ISSUED FOR BUILDING PERMIT	P.P.

STEREO
ARCHITECT YOUR PROJECT IS OUR MISSION

ARCHITECTURE AND INTERIOR DESIGN SERVICES
11 Ashworth Drive East, Vaughan, Ontario, L4N 1K7 CANADA



GOLFZON


PROJECT NAME: GOLFZON UNIT EXPANSION

PROJECT ADDRESS: 7501 WOODBINE AVENUE, MARKHAM, ONTARIO

DRAWING NAME: FLOOR PLAN

DATE: OCT. 24, 2011 PROJECT NO.: 11010

SCALE: 1/8" = 1'-0" DRAWING NO.: A-1

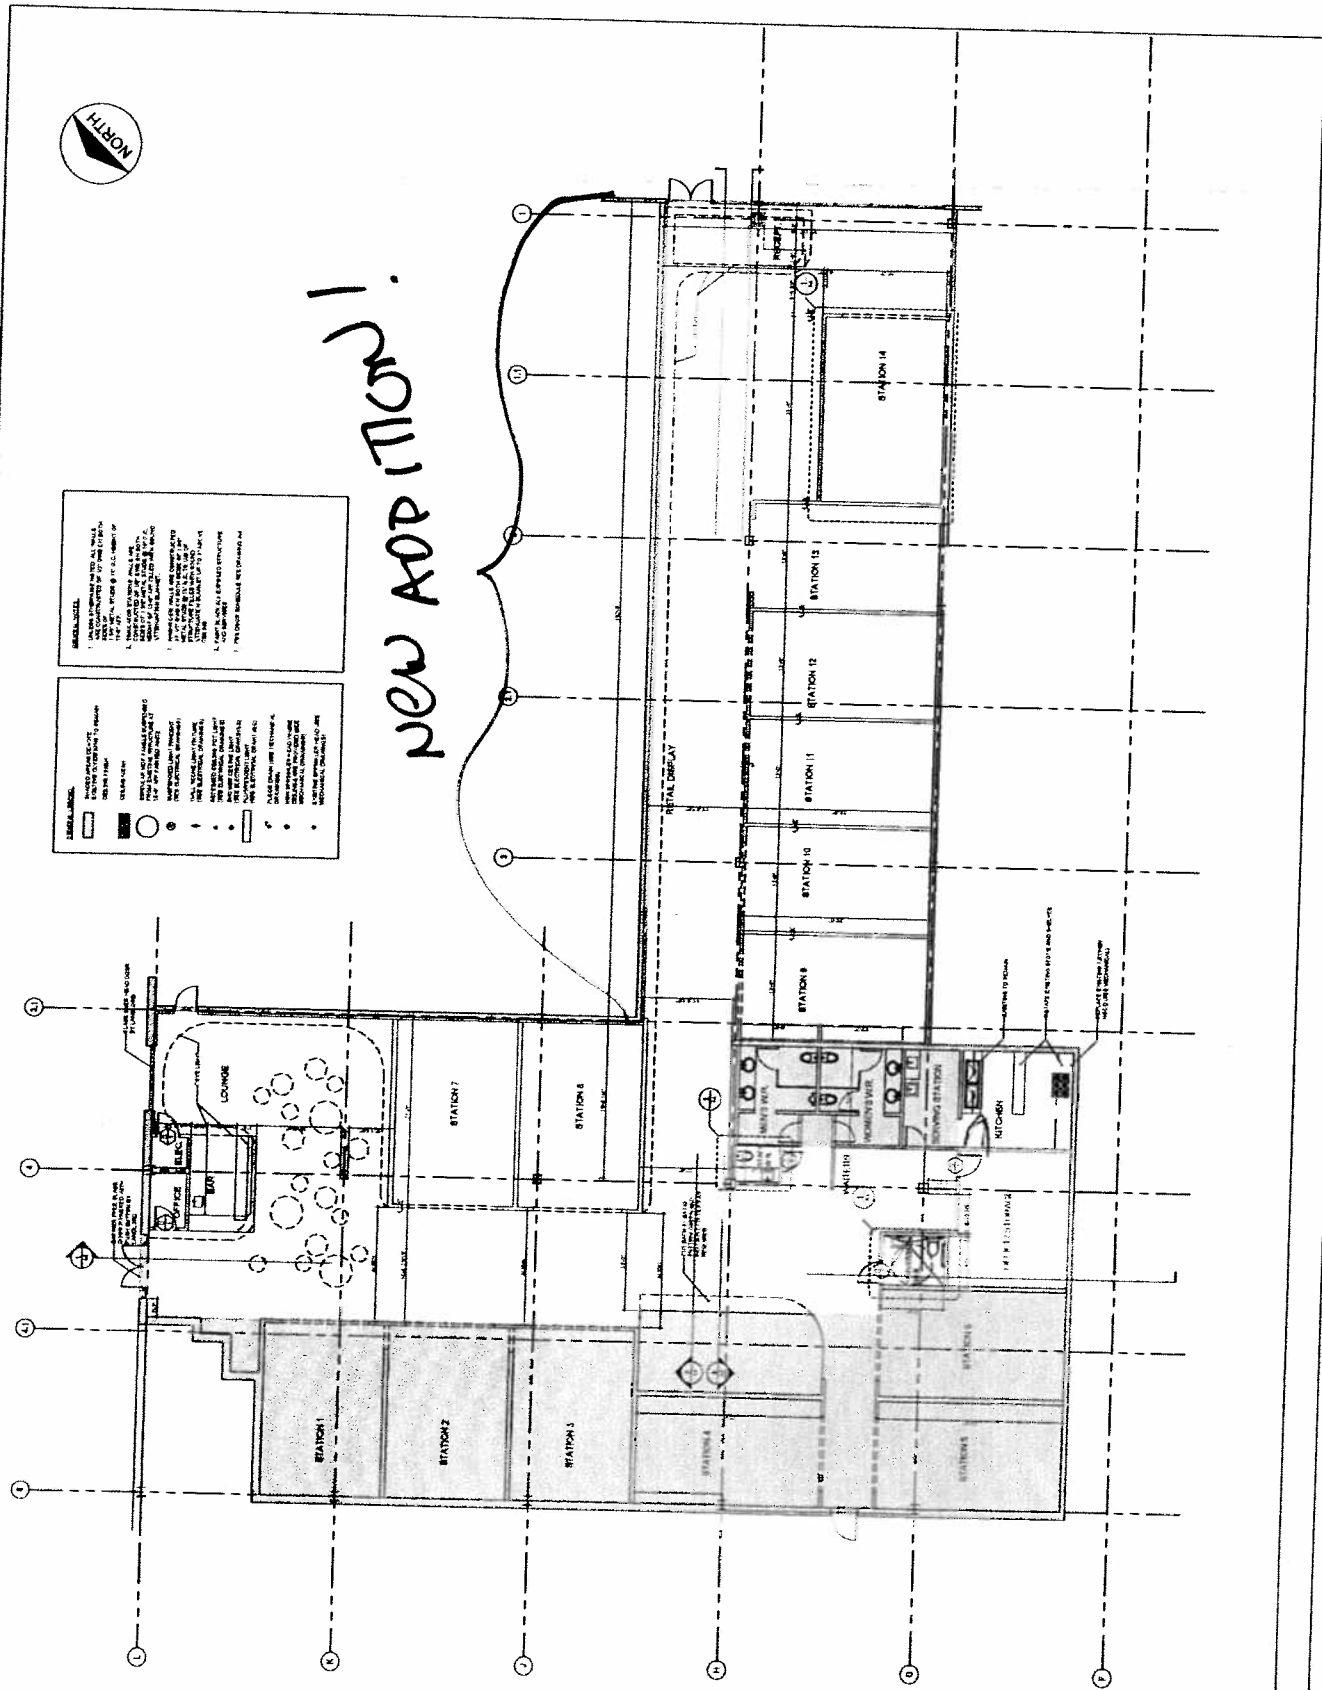

NEW MENU

APPETIZERS

- Slider 1 – Angus Beef, Sesame Seed Bun, Swiss Cheese, Carmelize Onions, Saute Mushrooms with french fries
- Slider 2 – Angus Beef, Sesame Seed Bun, Cheddar Cheese, Bacon, Lettuce, Pickle, Tomato with french fries
- Poutine – French Fries, Gravy, Cheese Curds
- Shrimp Cocktail – Jumbo Shrimp, Cocktail Sauce
- French Fries , Onion Rings, Sweet Potato Fries

MAINS

- Club Sandwich – Fresh Roasted Chicken, Bacon, Lettuce, Tomato, Mayo, Butter, Toasted Acient Grain Bread served with kettle chips
- Philly Cheese Steak Sandwich – Angus Striplion, Carmelized Red Onions, Saute Mushrooms, Saute Green Peppers, Monteray Jack Cheese, Sour Dough Bun with french fries
- Fajitas – Angus Striplion or Chciken Breast, Red and Orange Peppers, Saute Onions, Lettuces, Salsa, Sour Cream, Guacamole, Flour Tortilla with ?
- Chicken Wings
- Chicken Tenders with French fries
- Coconut Shrimp with French Fries

DRINKS

- Domestic Beer, Imported Beer, Premium Beer, Vodka Cooler
- White/Red Wine
- Premium and Standard Whisky, Vodka
- Espresso, Americano, Latte, Cappuccino

• POP / JUICE / SPOUT DRINK